


SITE PLAN OF PLOT NO. S-21 AT SECTOR NO. 11  
N OIDA COMPLEX (RESIDENTIAL AREA)


SCALE: 1:300

INDEX:

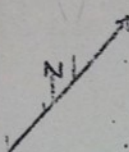

TOTAL AREA OF PLOT: 112.50 SQM.  
AREA OF PLOT TO BE HANDED OVER  
SHOWN IN RED.

2/11

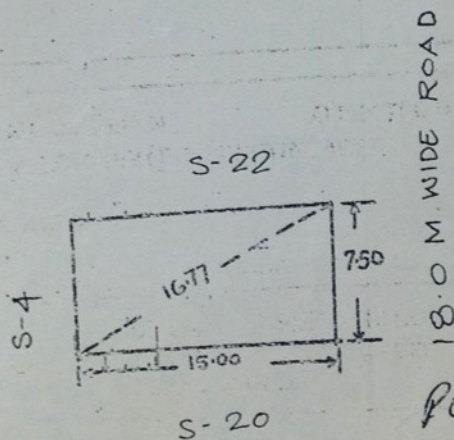

POSSESSION POSSESSION  
HANDLED TAKEN  
OVER OVER

By  
*[Signature]*  
15.12.80

By  
*[Signature]*  
15.12.80

DRAWN BY CHECKED BY

D/MAN  
NOIDA

A.P.E. (C)  
NOIDA

J.E. A.P.E. 28/12  
SECTOR-II SECTOR-II

MUNISHWAR KUMAR  
Junior Engineer  
Administration Dept.  
N. O. T. D. A.